

34

35381

807

Lauderdale
AAZ
2-68

MISSISSIPPI
BOARD OF WATER COMMISSIONERS
416 North State Street
Jackson, Mississippi 39201

WATER WELL DRILLERS LOG

2.13.68 date well completed McDonald + Hill firm name LAUDERDALE county well located

LANDOWNER: ~~JAMES FAIRCHILD~~
JAMES FAIRCHILD
P.O. 5 MERIDIAN
(mailing address)


WELL LOCATION:
sec. 33 T. 6 N. R. 15 E
5 miles NORTH of MERIDIAN
(distance) (direction) (nearest town)

WELL PURPOSE: HOME
(home, irrigation, municipal, industrial)

WELL COMPLETION DATA:

- (1) diameter (inches) 4"
- (2) total depth (feet) 290'
- (3) static water level (feet) 46' below top of ground.
- (4) casing PVC, 148' (material) (depth)
4" (size) if telescope see back.
- (5) screen NO, NO (length) (depth to top)
NO, NO (size) (material)
- (6) pump 1/2 JET 8 (HP) (yield gpm)
220 (type power)
- (7) electric log NO (yes or no)
NO (organization running log)
- (8) how well bottom plugged OPEN

description of formations encountered	from	to
clay st sand	0	12
shale	12	55
sandy	55	90
fine sand, st shale	90	120
soft shale	120	140
med shale	140	168
sandy	168	184
shale	184	202
fine sand	202	220
shale	220	270
fine sand	270	290

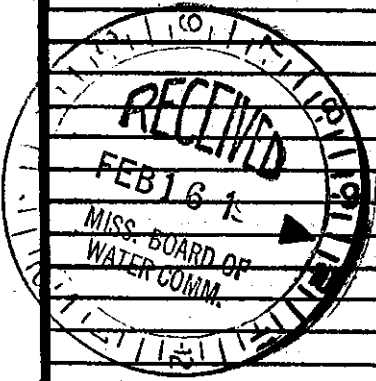

DRILLERS REMARKS: