

LAUDERDALE
G 35
8-67

MISSISSIPPI
BOARD OF WATER COMMISSIONERS
416 North State Street
Jackson, Mississippi 39201

WATER WELL DRILLERS LOG

8-30-1967 date well completed
Jury Dillingham firm name
Lauder county well located


LANDOWNER:
Mr. B.P. Green
26 ch. Ave. 14 St - City
(mailing address)

description of formations encountered	from	to
yellow clay	0	15
yellow sand	15	30
blue dirt	30	340
sandy streaks	340	348

WELL LOCATION:
sec. 20 T 7 N R 25 E
6 miles NW of Mendenhall
(distance) (direction) (nearest town)

WELL PURPOSE: Home
(home, irrigation, municipal, industrial)

- WELL COMPLETION DATA:
- (1) diameter (inches) 4"
 - (2) total depth (feet) 318'
 - (3) static water level (feet) 50' ^{below} above top of ground.
 - (4) casing (material) 126' (depth)
 - (size) If telescope see back.
 - (5) screen No (length) (depth to top)
 - (size) (material)
 - (6) pump 1/3 (HP) 600M (yrd gpm)
Salmege (type power)
 - (7) electric log No (yes or no)
(organization running log)
 - (8) how well bottom plugged Open
bottom

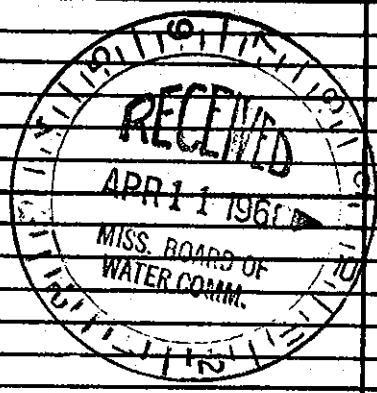

DRILLERS REMARKS: Very little sand in well-