

LAUDERDALE
G36
8-67

MISSISSIPPI
BOARD OF WATER COMMISSIONERS
416 North State Street
Jackson, Mississippi 39201

WATER WELL DRILLERS LOG

8-24-1967 Larry Dilling Laud
date well completed firm name county well located

LANDOWNER:
Mr. Lawrence Swaden
Rt 2, Meridian
(mailing address)

| description of formations encountered | from | to |
|---------------------------------------|------------|------------|
| <u>Yellow Clay & sand</u> | <u>0</u> | <u>35</u> |
| <u>Blue dirt</u> | <u>35</u> | <u>100</u> |
| <u>sand & dirt streaks</u> | <u>100</u> | <u>200</u> |
| <u>hard dirt</u> | <u>200</u> | <u>275</u> |
| <u>sandy</u> | <u>275</u> | <u>328</u> |

WELL LOCATION:
sec. 4 T. 7 N. R. 15 E.
8 miles N of MDN.
(distance) (direction) (nearest town)

WELL PURPOSE: home
(home, irrigation, municipal, industrial)

WELL COMPLETION DATA:

(1) diameter (inches) 4"

(2) total depth (feet) 328

(3) static water level (feet) 50 below above top of ground.


(4) casing Blk 212'
(material) (depth)
No if telescope see back.
(size)

(5) screen _____
(length) (depth to top)
(size) (material)

(6) pump 1/2 6
(HP) (yield gpm)
Submersa
(type power)

(7) electric log No
(yes or no)
(organization running log)

(8) how well bottom plugged open
bottom

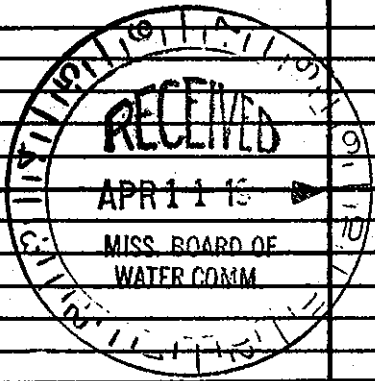

DRILLERS REMARKS: