

3 13P

322830N 0884800

TETU

Lauderdale
G 40
10-3-68

MISSISSIPPI  
 BOARD OF WATER COMMISSIONERS  
 416 North State Street  
 Jackson, Mississippi 39201

WATER WELL DRILLERS LOG

10.3.68 date well completed  
 McDonald + Hill firm name  
 LAUDERDALE CODER county well located

LANDOWNER: <u>OKATIBEE RESERVOIR EAST BANK</u>	description of formations encountered	from	to
		<u>CLAY ST SAND</u>	<u>0 20</u>
		<u>SHALE</u>	<u>20 140</u>
	<u>SAND</u>	<u>140 250</u>	

(mailing address)


WELL LOCATION:

sec. 6 T 7 N R 15 E  
 S W  
3 miles SEAST of Collinsville  
 (distance) (direction) (nearest town)

WELL PURPOSE:  
 (home, irrigation, municipal, industrial)

WELL COMPLETION DATA:

- (1) diameter (inches) 4" TEST HOLE
- (2) total depth (feet) 250'
- (3) static water level (feet) 80' below top of ground.
- (4) casing GALV, 230'  
 (material) (depth)  
2" if telescope see back.  
 (size)
- (5) screen 16', 230'  
 (length) (depth to top)  
2", BRASS  
 (size) (material)
- (6) pump RIG, 50  
 (HP) (yield gpm)  
GAS  
 (type power)
- (7) electric log NO  
 (yes or no)  
NO  
 (organization running log)
- (8) how well bottom plugged VALVE

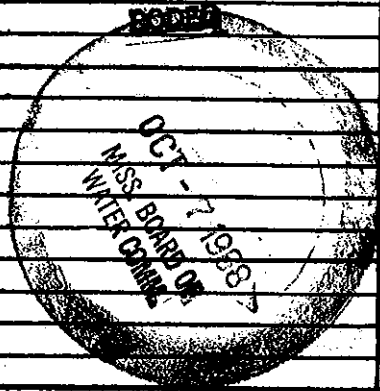

DRILLERS REMARKS: