

Lauderdale
 G4
 10-2-68
 USES
 10.2.68

MISSISSIPPI
 BOARD OF WATER COMMISSIONERS
 416 North State Street
 Jackson, Mississippi 39201

WATER WELL DRILLERS LOG

McDONALD + KILL LAUDERDALE
 firm name county well located

LANDOWNER: OKATIBBE RESERVOIR WEST BANK

description of formations encountered	CODED	to
CLAY	0	10
CLAY ST SAND	10	17
SHALE	17	24
YELLOW SAND	24	70
CLAY	70	80
SHALE	80	150
SHALE ST LIGNITE	150	170
FINE SAND	170	190
SHALE	190	210
SOFT SHALE ST LIGNITE	210	240
SHALE	240	370
FINE SAND ST SHALE	370	430
SHALE	430	470
SOFT SHALE	470	490
SAND	490	559


(mailing address)

WELL LOCATION:
 sec. 6 T. 7 N. R. 15 E
3 miles S EAST of COLLINSVILLE
 (distance) (direction) (nearest town)

WELL PURPOSE: MUNICIPAL
 (home, irrigation, municipal, industrial)

WELL COMPLETION DATA:

- (1) diameter (inches) 4" TEST HOLE
- (2) total depth (feet) 559'
- (3) static water level (feet) 85' below top of ground.
- (4) casing GALV 525'
 (material) (depth)
2"
 (size) If telescope see back.
- (5) screen 16' 325
 (length) (depth to top)
2" BRASS
 (size) (material)
- (6) pump WELL RIG 50
 (HP) (yield gpm)
GAS
 (type power)
- (7) electric log YES
 (yes or no)
US G S CO
 (organization running log)
- (8) how well bottom plugged VALVE

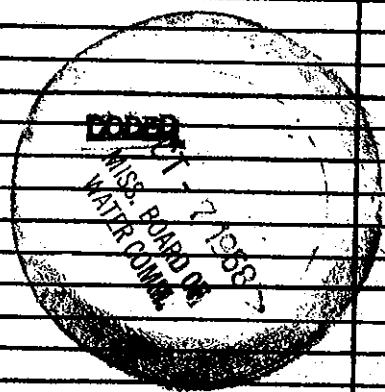

DRILLERS REMARKS: