

LAUD.

MISSISSIPPI BOARD OF WATER COMMISSIONERS

G 90

WATER WELL DRILLERS LOG

**CODED**

10-25-63

Date: 10-25, 1963, Driller: MCDONALD & HILL, Inc. County: Lauderdale  
(Name)

(1) Owner of Land: <u>Tommy Joyner</u> (Name)	Description & Color of Materials Sand, Clay, Red Clay, Shell, etc.	Thick- ness Feet	Depth Feet
<u>Rt. 1 Baley, Miss.</u> (Address)	<u>Clay</u>	<u>0</u>	<u>45</u>
(2) Location: <u>3 7 15</u> T. <u>3</u> R. <u>15</u>	<u>Shale</u>	<u>45</u>	<u>175</u>
<u>2 1/2</u> miles <u>NW</u> of <u>Meridian</u> (distance) (direction) (Nearest Town)	<u>Shale &amp; Fine</u>	<u>175</u>	<u>230</u>
(3) Topography: _____ (Hilly) (Flat) (Level)			
(4) Purpose of Well: <u>Domestic</u> (Domestic Irrigation Municipal, Industrial, Other)			

Information upon completion of well:


- (1) Diameter 3 inches.
- (2) Total Depth 230 feet.
- (3) Water Level 75 feet below top of ground.
- (4) Cased to 105, Size 3
- (5) Screen: Size \_\_\_\_\_, Length \_\_\_\_\_
- (6) Were any formations sealed against pollution?  
 yes,  no.

If YES depth of formation \_\_\_\_\_

Why \_\_\_\_\_

Drillers Remarks: \_\_\_\_\_

**CODED**

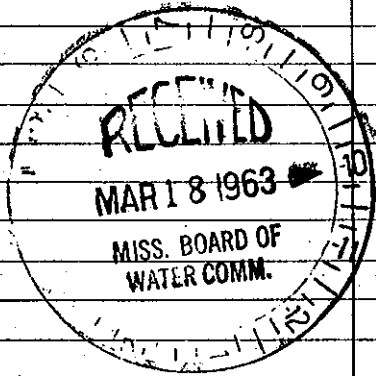

Well No.

(Use Back Side)

Retain this copy for your office files.