

MISSISSIPPI BOARD OF WATER COMMISSIONERS

WATER WELL DRILLERS LOG

CODED

LAL
G 91
11-4-63

Date: 11-4, 1963, Driller: M. E. Donald & Hill, Inc County Lauderdale
(Name)

(1) Owner of Land: LAMAR SKINNER
(Name)
R# 2 MERIDIAN
(Address)

(2) Location: 20 1/2 miles NORTH of MERIDIAN
(distance) (direction) (Nearest Town)

(3) Topography: _____
(Hilly) (Flat) (Level)

(4) Purpose of Well: _____
(Domestic Irrigation, Municipal, Industrial, Other)

Description & Color of Materials Sand, Clay, Red Clay, Shell, etc.	Thick- ness Feet	Depth Feet
<u>CLAY</u>	<u>0</u>	<u>10</u>
<u>SHALE</u>	<u>10</u>	<u>25</u>
<u>SAND ST SHALE</u>	<u>25</u>	<u>55</u>
<u>FINE SAND</u>	<u>55</u>	<u>90</u>
<u>SOFT SHALE</u>	<u>90</u>	<u>130</u>
<u>SHALE</u>	<u>130</u>	<u>175</u>
<u>SAND</u>	<u>175</u>	<u>200</u>

Information upon completion of well:

(1) Diameter 4" inches.

(2) Total Depth 200' feet.

(3) Water Level 40' feet below top of ground.

(4) Cased to 147', Size 4"

(5) Screen: Size _____, Length _____


(6) Were any formations sealed against pollution?
_____ yes, _____ no.

If YES depth of formation _____

Why _____

Drillers Remarks: _____

CODED

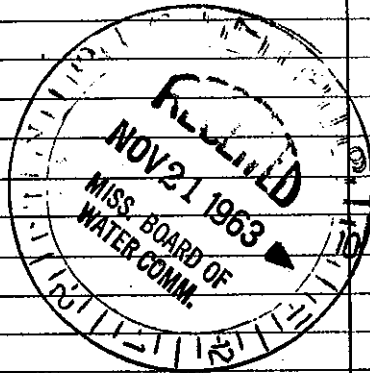

Well No.

(Use Back Side)

Mail this copy to Board of Water Commissioners 429 Miss. St. Jackson, Miss.