

LAUD.
G-92
1-30-64

MISSISSIPPI BOARD OF WATER COMMISSIONERS

WATER WELL DRILLERS LOG

CODED

Date: 1-30, 1964, Driller: Duy County Laud

(1) Owner of Land: H. R. Chandler

Description & Color of Materials
Sand, Clay, Red Clay, Shell, etc.

Thick-
ness
Feet

Depth
Feet

(Name)
Chandler Rd, Meridian
(Address)

yellow clay
Sandy Shale
Shale & mud
Sandy

0 42
42 140
120 280
280 320

(2) Location: 1/4, 34 7 15

4 miles N of MDN
(distance) (direction) (Nearest Town)

(3) Topography: _____
(Hilly) (Flat) (Level)

(4) Purpose of Well: Domestic
(Domestic Irrigation
Municipal, Industrial, Other)

CODED

Information upon completion of well:

(1) Diameter 4 inches.

(2) Total Depth 320 feet.

(3) Water Level 50 feet below top of ground.

(4) Cased to 130', Size 4"

(5) Screen: Size No., Length _____


(6) Were any formations sealed against pollution?

_____ yes, _____ no.

If YES depth of formation _____

Why _____

Drillers Remarks: well pumped
100 gpm without strainer -
pumped with air -

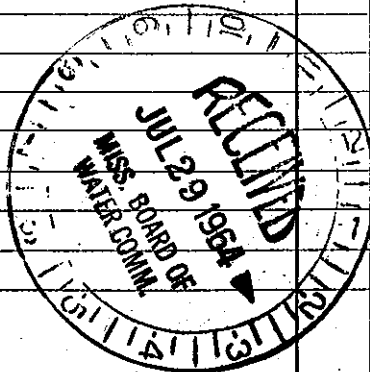

(Use Back Side)

Well No. _____

Mail this copy to Board of Water Commissioners 429 Miss. St. Jackson, Miss