

**WATER WELL DRILLERS LOG**

**CODED**

LAUD.  
G 93,  
Date: 6-1, 1965, Driller: Bob Williamson County Laud  
(Name)

(1) Owner of Land:	Description & Color of Materials Sand, Clay, Red Clay, Shell, etc.	Thick- ness Feet	Depth Feet
<u>W. F. Scott</u> (Name)	<u>Red sand</u>	<u>36</u>	<u>1-30</u>
<u>Bailey, Miss</u> (Address)	<u>Blue clay</u>	<u>225</u>	<u>30-255</u>
(2) Location: <u>1/4</u> , <u>2</u> , Sec. <u>7 15</u>	<u>fine gray sand</u>	<u>41</u>	<u>255-296</u>
<u>15</u> miles <u>North</u> , of <u>Merida</u> (distance) (direction) (Nearest Town)			
(3) Topography: <u>hilly</u> (Hilly) (Flat) (Level)			
(4) Purpose of Well: <u>domestic</u> (Domestic Irrigation Municipal, Industrial, Other)			

**CODED**


Information upon completion of well:

- (1) Diameter 2 inches.
- (2) Total Depth 296 feet.
- (3) Water Level 188 feet below top of ground.
- (4) Cased to 226, Size 2"
- (5) Screen: Size 0, Length \_\_\_\_\_
- (6) Were any formations sealed against pollution?  
 yes, \_\_\_\_\_ no.

If YES depth of formation \_\_\_\_\_

Why surface water

Drillers Remarks: \_\_\_\_\_

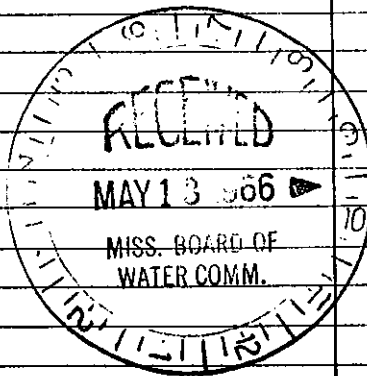

(Use Back Side)

Well No.

tain this copy for your office files.