

LAUDERDALE
 5111
 6-15-73
 Eng # 58
 6/15/73

MISSISSIPPI
 BOARD OF WATER COMMISSIONERS
 416 North State Street
 Jackson, Mississippi 39201

CODED

WATER WELL DRILLERS LOG

Jerry Drilling Land
 firm name county well located

LANDOWNER:

Janglwood Estates
 Rt 9, Mdn. Miss.
 (mailing address)

description of formations encountered

from to

yellow clay	0	22
sandy	22	40
clay & sand	40	65
sandy shale	65	120
clay	120	245
fine sand	245	295

WELL LOCATION:


sec. 29 T 7 N R 15 E
 4 miles NW of Mdn.
 (distance) (direction) (nearest town)

WELL PURPOSE: housing project
 (home, irrigation, municipal, industrial)

WELL COMPLETION DATA:

CODED

- (1) diameter (inches) 8"
- (2) total depth (feet) 295'
- (3) static water level (feet) 61 ^{below} _{above} top of ground.
- (4) casing steel, 250'
 (material) (depth)
4"
 (size) if telescope see back.
- (5) screen 40' 250'
 (length) (depth to top)
4", Stainless Steel
 (size) (material)
- (6) pump 10 90
 (HP) (yield gpm)
sub
 (type power)
- (7) electric log yes
 (yes or no)
U.S.G.S
 (organization running log)
- (8) how well bottom plugged crack
value

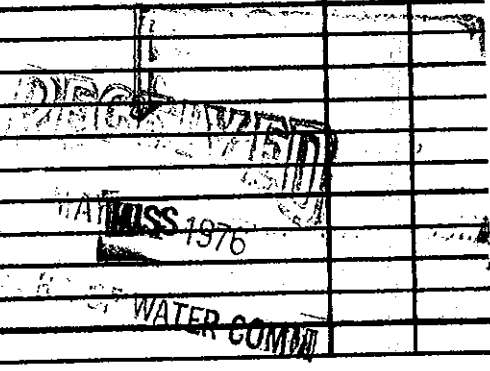

DRILLERS REMARKS:

Well very weak -
 pumps jacked 199F
 D.P.