

LANDOWNER  
 2098

MISSISSIPPI  
 BOARD OF WATER COMMISSIONERS  
 416 North State Street  
 Jackson, Mississippi 39201

WATER WELL DRILLERS LOG

316-87 19 POOLE WELL DRILLING WADSWORTH  
 date well completed firm name county well located

LANDOWNER: JAMES W. AINE

description of formations encountered	from	to
TOP 4" LAY SAND	0'	8'
4" LAY SAND	8'	17'
17" LAY SAND	17'	30'
30" LAY LIGN	30'	60'
60" LAY SHALE	60'	160'
160" LAY SAND	160'	190'
190" LAY BLUE SHALE	190'	215'
215" LAY GREEN SAND	215'	340'


Rt, 2 MERRIDIAN  
 (mailing address)

WELL LOCATION:  
 sec. 33 T-7N R-15E  
 2 miles NORTH of MERRIDIAN  
 (distance) (direction) (nearest town)

WELL PURPOSE: HOME  
 (home, irrigation, municipal, industrial)

WELL COMPLETION DATA:

- (1) diameter (inches) 4"
- (2) total depth (feet) 340
- (3) static water level (feet) 17 below top of ground
- (4) casing 4" 140'  
 (material) (depth)
- (5) screen  
 (length) (depth to top)
- (6) pump 1/2 HP 3  
 (HP) (yield gpm)
- (7) electric log NO  
 (yes or no)
- (8) how well bottom plugged OPEN

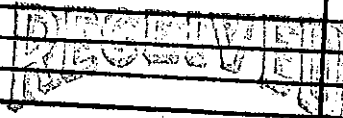

MAR 01 1987

Department of Natural Resources  
 Bureau of Land & Water Resources

DRILLERS REMARKS: