

MISSISSIPPI BOARD OF WATER COMMISSIONERS

M. O. N.

WATER WELL DRILLERS LOG

2-60

Date: ~~Aug 2~~ Aug 2, 1960, Driller: Barry Drilling Co. - County Lauderdale
 Driller - ^(Name) Robert Hall

(1) Owner of Land: H. H. Russell
 (Name)
Rt. 2, Meridian, Miss.
 (Address)

(2) Location: 1/4, 1/4, Sec. 26 T. 15 N R. 15 E
Strickland Road
1/4 miles North West, of Meridian
 (distance) (direction) (Nearest Town)

(3) Topography: (Hilly) (Flat) (Level)

(4) Purpose of Well: Domestic
 (Domestic Irrigation
 Municipal, Industrial, Other)

Description & Color of Materials Sand, Clay, Red Clay, Shell, etc.	Thick- ness Feet	Depth Feet
<u>Red Clay + yellow sand</u>	<u>0 - 22'</u>	
<u>Yellow sand</u>	<u>22' - 44'</u>	
<u>Streaks of mud + yellow sand</u>	<u>44' - 86'</u>	
<u>Streaks, gray dirt + blue sand</u>	<u>86' - 107'</u>	
<u>Gray mud</u>	<u>107' - 128'</u>	
<u>Streaky, gray dirt + gray sand</u>	<u>128' - 254'</u>	
<u>Solid gray sand</u>	<u>254' - 275'</u>	

Information upon completion of well:

(1) Diameter 3 inches.

(2) Total Depth 275 feet.

(3) Water Level ~~275~~ 130 feet below top of ground.

(4) Cased to 168', Size 3"


(5) Screen: Size open well, Length _____

(6) Were any formations sealed against pollution?
 yes, _____ no.

If YES depth of formation 168'

Why # casing set in dirt

Drillers Remarks: _____

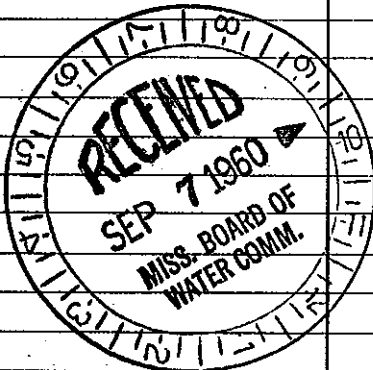

Well No.

(Use Back Side)

copy for your office files.