

MISSISSIPPI BOARD OF WATER COMMISSIONERS

WATER WELL DRILLERS LOG

3-60

6302

Date: aug 18, 1960, Driller: Perry Drilling Co County Lauderdale
 Driller (Name) Robert Hall

(1) Owner of Land:	Description & Color of Materials Sand, Clay, Red Clay, Shell, etc.	Thick- ness Feet	Depth Feet
<u>T.O. Patch</u> (Name) <u>Bailey, Miss.</u> (Address)	<u>Red clay</u>	<u>0</u>	<u>22'</u>
	<u>Gray mud</u>	<u>22'</u>	<u>44'</u>
(2) Location: <u>1/4</u> , <u>1/4</u> , Sec. <u>1</u> <u>T</u> <u>R</u>	<u>Strata - Gray mud + gray sand</u>	<u>44'</u>	<u>88'</u>
<u>1</u> miles <u>North</u> of <u>Bailey</u>	<u>Gray mud</u>	<u>88'</u>	<u>172'</u>
(3) Topography: <input checked="" type="checkbox"/> (Hilly) <input type="checkbox"/> (Flat) <input type="checkbox"/> (Level)	<u>Mixed gray dirt & sand</u>	<u>172'</u>	<u>283'</u>
(4) Purpose of Well: <u>Domestic</u>	<u>Rock, sand & blue dirt</u>	<u>283'</u>	<u>234'</u>
(Domestic Irrigation, Municipal, Industrial, Other)	<u>Mixed blue dirt + gray sand</u>	<u>234'</u>	<u>255'</u>
	<u>Gray dirt + Strata sand</u>	<u>255'</u>	<u>296'</u>
	<u>Light gray sand</u>	<u>296'</u>	<u>288'</u>
	<u>Gray dirt</u>	<u>288'</u>	<u>297'</u>


Information upon completion of well:

- (1) Diameter 3 inches.
- (2) Total Depth 297 feet.
- (3) Water Level 115 feet below top of ground.
- (4) Cased to 168', Size 3"
- (5) Screen: Size Open well, Length _____
- (6) Were any formations sealed against pollution?
 yes, no.

If YES depth of formation 172'

Why Casing set in firm dirt

Drillers Remarks: _____

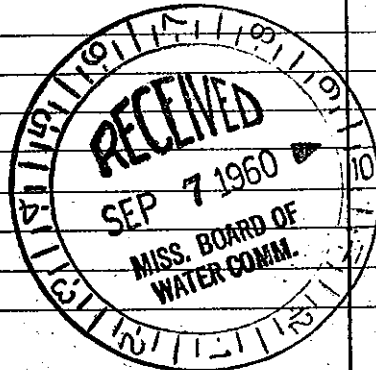

(Use Back Side)

Well No.