

MISSISSIPPI BOARD OF WATER COMMISSIONERS

WATER WELL DRILLERS LOG

9-15-60


6301

Date: Sept. 15, 1960, Driller: Perry Drilling Co. County Lauderdale
Robert Hall - Driller

(1) Owner of Land:	Description & Color of Materials Sand, Clay, Red Clay, Shell, etc.	Thick- ness Feet	Depth Feet
<u>D. F. McKee</u> (Name)	<u>Red sandy clay</u>	<u>0</u>	<u>44'</u>
<u>Bailey, Miss</u> (Address)	<u>Gray mud</u>	<u>44'</u>	<u>193'</u>
(2) Location: <u>1/4, 1/4, Sec. 1</u> <u>7 N 1/4 E</u>	<u>Strata of gray mud sand</u>	<u>193'</u>	<u>319'</u>
<u>1</u> miles <u>North</u> , of <u>Bailey</u> (distance) (direction) (Nearest Town)			
(3) Topography: <input checked="" type="checkbox"/> (Hilly) <input type="checkbox"/> (Flat) <input type="checkbox"/> (Level)			
(4) Purpose of Well: <u>Domestic</u> (Domestic Irrigation Municipal, Industrial, Other)			

Information upon completion of well:

- (1) Diameter 3 inches.
- (2) Total Depth 319 feet.
- (3) Water Level 155 feet below top of ground.
- (4) Cased to 168', Size 3"
- (5) Screen: Size open well, Length _____
- (6) Were any formations sealed against pollution?
yes, _____ no.

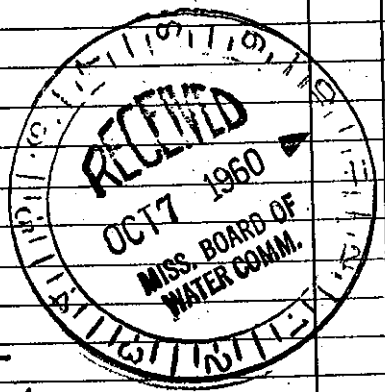

Why Casing set in firm dirt
then drilled inside 7.5" pipe.
 Drillers Remarks: