

MISSISSIPPI BOARD OF WATER COMMISSIONERS

WATER WELL DRILLERS LOG

**CODED**

74  
-60  
9/15, 1960, Driller: McDonald Hill County Lauderdale  
(Name)


(1) Owner of Land: Otto Woods  
(Name)  
Rt 5 mdr  
(Address)  
(2) Location: 30 1/4, 7 Sec. 15 T. R.  
miles \_\_\_\_\_ of \_\_\_\_\_  
(distance) (direction) (Nearest Town)  
(3) Topography: Hilly  
(Hilly) (Flat) (Level)  
(4) Purpose of Well: Domestic  
(Domestic Irrigation  
Municipal, Industrial, Other)

Description & Color of Materials Sand, Clay, Red Clay, Shell, etc.	Thick- ness Feet	Depth Feet
Clay + Sandy clay	0	18
Lignite + Sandy mud	18	35
marl	35	100
marl + sand str.	100	112
Sandy shale + fine sand	112	135
marl	135	145
Sand str.	145	150
fine sand	150	160
marl + lime	160	210
Sandy shale, fine sand	210	220
marl + sandy shale str.	220	239
marl	239	260

Information upon completion of well:

(1) Diameter 3 inches.  
(2) Total Depth 270 feet.  
(3) Water Level 43 feet below top of ground.  
(4) Cased to 105, Size 3 in.  
(5) Screen: Size \_\_\_\_\_, Length \_\_\_\_\_  
(6) Were any formations sealed against pollution?  
\_\_\_\_\_ yes,  no.

**CODED**

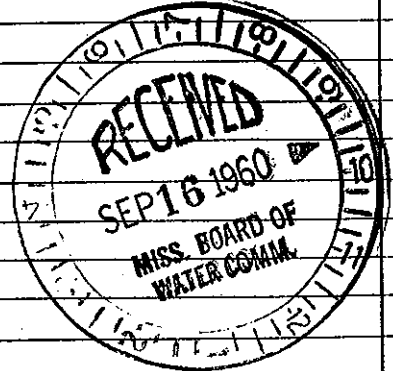

If YES depth of formation \_\_\_\_\_  
Why \_\_\_\_\_  
Drillers Remarks: \_\_\_\_\_

Well No.

(Use Back Side)