

MISSISSIPPI BOARD OF WATER COMMISSIONERS

WATER WELL DRILLERS LOG

0.  
A  
7-6-60

6303


Date: July 6, 1960, Driller: Perry Drilling Co. County Lauderdale  
(Name Robert Hall Driller)

(1) Owner of Land: D. M. Doerner  
(Name)  
Bailey Miss  
(Address)  
(2) Location: 1 7/16 SE  
1 miles North of Bailey, Miss  
(distance) (direction) (Nearest Town)  
(3) Topography:  (Hilly)  (Flat)  (Level)  
(4) Purpose of Well: Domestic  
(Domestic Irrigation  
Municipal, Industrial, Other)

Description & Color of Materials Sand, Clay, Red Clay, Shell, etc.	Thick- ness Feet	Depth Feet
<u>Red Clay</u>	<u>20'</u>	<u>20'</u>
<u>Blue dirt</u>	<u>46'</u>	<u>66'</u>
<u>Strata dirt + sand</u>	<u>66'</u>	<u>169'</u>
<u>Jeff blue dirt</u>	<u>169'</u>	<u>172'</u>
<u>Mixed dirt + sand</u>	<u>172'</u>	<u>214'</u>
<u>Gray dirt</u>	<u>214'</u>	<u>235'</u>
<u>Strata mud + sand</u>	<u>235'</u>	<u>320'</u>

Information upon completion of well:

(1) Diameter 3 inches.  
(2) Total Depth 320 feet.  
(3) Water Level 130 feet below top of ground.  
(4) Cased to 169', Size 3"  
(5) Screen: Size \_\_\_\_\_, Length \_\_\_\_\_  
(6) Were any formations sealed against pollution?  
Yes, \_\_\_\_\_ no.  
If YES depth of formation 3'  
Why Casing set in hard dirt  
Drillers Remarks:

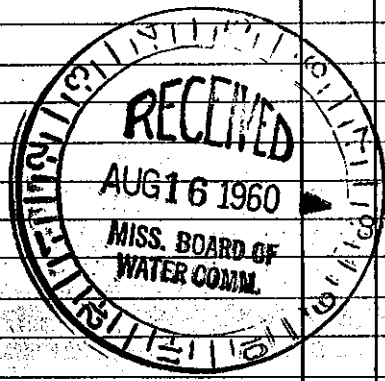

Well