


WATER WELL DRILLERS LOG

Date: 11/29, 1965, Driller: Jerry County Land

(1) Owner of Land: U.S. Sugar Plant (Name) RT6 MERIDIAN (Address) 7 1/2 (3) Topography: (Hilly) (Flat) (Level) (4) Purpose of Well: Irrigation (Domestic Irrigation, Municipal, Industrial, Other)	
(2) Location: 6 miles NE of MDN (distance) (direction) (Nearest Town) 7 1/2 Sec. 36 T. 16 N. R. 16 E.	
Description & Color of Materials Sand, Clay, Red Clay, Shell, etc.	Depth Thick- ness Feet Feet
RED SAND & CLAY	0 42
BLUE DIRT	42 120
SAND	120 180
BLUE DIRT & ROCK	180 350
SAND	350 500
SAND & SHALE	500 800
SAND	800 490

Information upon completion of well:

- (1) Diameter 10 inches.
 - (2) Total Depth 490 feet.
 - (3) Water Level 200 feet below top of ground.
 - (4) Cased to 440, Size 10"
 - (5) Screen: Size 6", Length 50"
 - (6) Were any formations sealed against pollution? _____
 Yes, _____ no.
- If YES depth of formation _____
- Why _____
- Drillers Remarks: WELL PUMPED 508 gpm

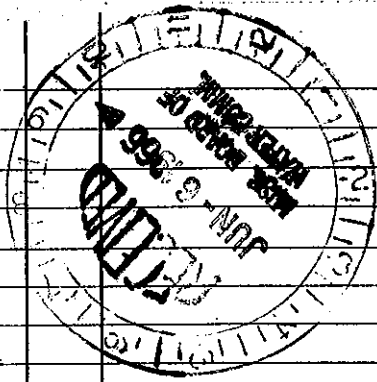

Well