


at all this copy to Board of Water Commissioners 429 Miss. St. Jackson, Miss.

Well No.

(Use Back Side)

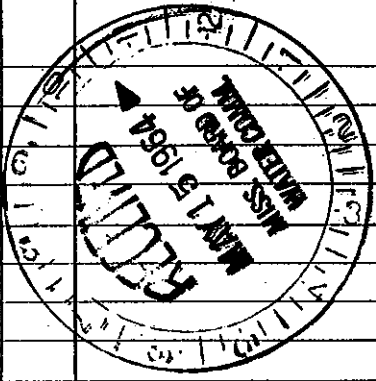

Information upon completion of well:

(1) Diameter 2 inches.

(2) Total Depth 230 feet.

(3) Water Level 115 feet below top of ground.

(4) Cased to 125, Size 2 in.

(5) Screen: Size 10, Length _____.

(6) Were any formations sealed against pollution? Yes, _____ no.

If YES depth of formation unaffected

Why _____

Drillers Remarks: _____

(1) Owner of Land: Jack Smith (Name)

3705 Highway 39 North (Address)

(2) Location: NE 1/4, NW 1/4, Sec. 30 T12N14E3

1 miles North, of Meridian, (direction) (Nearest Town)

(3) Topography: Hilly (Hilly) (Level)

(4) Purpose of Well: Domestic (Domestic Irrigation, Industrial, Other)

Thick- ness Feet	Depth Feet	Description & Color of Materials Sand, Clay, Red Clay, Shell, etc.
------------------------	---------------	---

20	12-20	White chalk
10	20-30	Blue clay
30	30-60	Light sand
10	60-70	Light sand
65	70-135	Light clay
15	135-150	Light sand
50	150-200	Light clay
30	200-230	Light sand

WATER WELL DRILLERS LOG

Date: April 16, 1964, Driller: Bob Williamson County Lauderdale

14