

MISSISSIPPI BOARD OF WATER COMMISSIONERS

WATER WELL DRILLERS LOG

9-25-64
H7

Date: 9/25, 1964, Driller: DIVERSITY CO. COUNTY: LAUD

(Name)

(1) Owner of land: 66 Truck Stop

(Name) RT 4 Hwy 45 N. M.D.N. (Address) 7N 116

(2) Location: 1/4, Sec. 27, T. R. 100' 450' 60' 350'

(3) Topography: (Hilly) (Flat) (Level) 3 miles NE of M.D.N. (distance) (direction) (Nearest Town)

(4) Purpose of Well: Commercial (Domestic Irrigation, Municipal, Industrial, Other)

Information upon completion of well:


- (1) Diameter: 7 inches.
- (2) Total Depth: 502 feet.
- (3) Water Level: 90' feet below top of ground.
- (4) Cased to: 212' Size: 4"
- (5) Screen: Size: 2" Length: 25'
- (6) Were any formations sealed against pollution? yes, no.

If YES depth of formation

Why

Drillers Remarks:

Depth Feet	Thick-ness Feet	Description & Color of Materials Sand, Clay, Red Clay, Shell, etc.
90-90'		Clay & sand
90-90'		Clay & sand
60-350'		Clay & sand
100'-450'		Sandy shale
52-502		Sand (good)

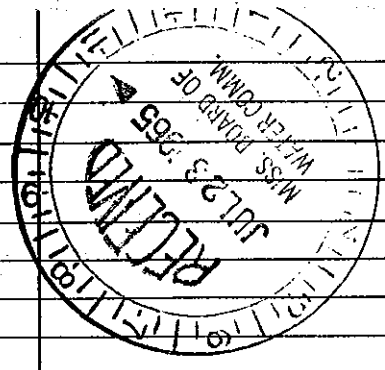

Well