

MISSISSIPPI BOARD OF WATER COMMISSIONERS

WATER WELL DRILLERS LOG


L.A.O. HS

3-25-65

Date: 3/25, 1965, Driller: TERRY

County: KANE

Well	Depth Feet	Thickness Feet	Description & Color of Materials Sand, Clay, Red Clay, Shell, etc.
	20		gallon sand
			white slush (90' to 100')
			blue dirt
			blue dirt & sand
			slush
			217 408'

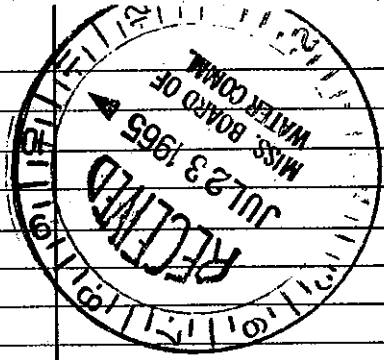

Information upon completion of well:

(1) Diameter: 4 inches.

(2) Total Depth: 408 feet.

(3) Water Level: 20 feet below top of ground.

(4) Cased to: 191 feet, Size: 4" length.

(5) Screen: Size: No length.

(6) Were any formations sealed against pollution?  yes,  no.

If YES depth of formation: \_\_\_\_\_

Why: \_\_\_\_\_

Drillers Remarks: WELL PUMPED 100 GPM

(1) Owner of Land: SERVICE CONST. CO. (Name)

M.R. D. I. A. N. I. M. S. S. (Address)

(2) Location: 1/4, Sec. 1 R, 1/4, Sec. 1 R, 1/4, Sec. 1 R

1 miles NE of M.D.R. (distance)

FLAT (Nearest Town)

(3) Topography: FLAT (Hilly) (Flat) (Level)

(4) Purpose of Well: WAREHOUSE (Domestic Irrigation, Industrial, Other)