

LAUD. MISSISSIPPI BOARD OF WATER COMMISSIONERS

WATER WELL DRILLERS LOG

H/0
11-12-65


Date: 11/12, 1965, Driller: JERRY County Laud

(1) Owner of Land: JAMIE HARDIS (Name)
MARION, Miss. (Address)
7th 166 1/2, Sec. 22, T. 1 R.

(2) Location: 5 miles North of MDN. (direction) (Nearest Town)
(3) Topography: (Hilly) (Flat) (Level)
(4) Purpose of Well: Domestic (Municipal, Industrial, Other)

Information upon completion of well:
(1) Diameter: 4 inches.
(2) Total Depth: 412 feet.
(3) Water Level: 68 feet below top of ground.
(4) Cased to: 212 Size: 4
(5) Screen: Size: 1/2 Length: _____
(6) Were any formations sealed against pollution? _____ yes, _____ no.

If YES depth of formation _____
Why _____
Drillers Remarks: yellow water.

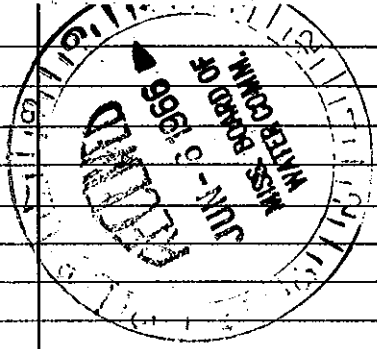

Description & Color of Materials Sand, Clay, Red Clay, Shell, etc.	Thick- ness Feet	Depth Feet
Yellow sand	0	35
Sandy shale	35	125
Hard shale	125	320
Sandy	320	412

We