

MISSISSIPPI
 BOARD OF WATER COMMISSIONERS
 416 North State Street
 Jackson, Mississippi 39201

WATER WELL DRILLERS LOG

AUBERDALE
 H 11
 7-67

date well completed

9-7-

firm name

101 Jimmy Building

county well located

DeWitt

LANDOWNER:

M. J. White

WELL LOCATION:

(mailing address)

414 Meridian Ave

sec

27 1 N

miles

3 1/2 NE 1/4

(distance) (direction) (nearest town)

WELL PURPOSE:

(home, irrigation, municipal, industrial)

farm

WELL COMPLETION DATA:

(1) diameter (inches)

4"

(2) total depth (feet)

386

(3) static water level (feet)

70 above

(4) casing (material) (depth)

2 1/2" 10'

(5) screen (size)

No

if telescope see back.

(6) pump (size)

1 1/2"


(7) electric log (yes or no)

No

(8) how well bottom plugged

open

DRILLERS REMARKS:

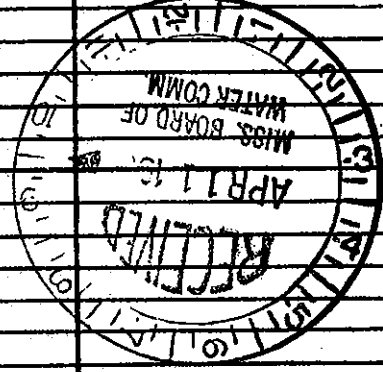

description of formations encountered	from	to
yellow sand shale	0	35
blue sand shale	35	85
blue dirt	85	240
pink shales	240	300
blue shale	300	340
blue - green	340	386