

LAUD. MISSISSIPPI BOARD OF WATER COMMISSIONERS

WATER WELL DRILLERS LOG

H 12  
11-26-66

Date: 11/30, 1966, Driller: TERRY, County: AUD

(Name)

(1) Owner of Land: Northwood Country Club  
Description & Color of Materials: sand, clay, red clay, shell, etc.  
Thick-ness Feet: 0  
Depth Feet: 65

(Name) SANDY  
SHALE & SAND MIXED 65-125

(Address) SAND 125-150  
SHALE 150-155

(2) Location: 1/4, NE 30 7/8 Sec. 30 7/8 R. 15  
Solid SAND 155-290

(distance) miles N of M.D.N.  
(direction)

(3) Topography: (Hilly) (Flat) (Level)

(4) Purpose of Well: IRRIGATION  
(Domestic Irrigation, Industrial, Other)

Information upon completion of well:

(1) Diameter 6 inches.

(2) Total Depth 290 feet.

(3) Water Level 61 feet below top of ground.

(4) Cased to 6" Size 255


(5) Screen: Size 4 Length 45

(6) Were any formations sealed against pollution? no.

If YES depth of formation

Why

Drillers Remarks: WELL PUMPS 275 gpm

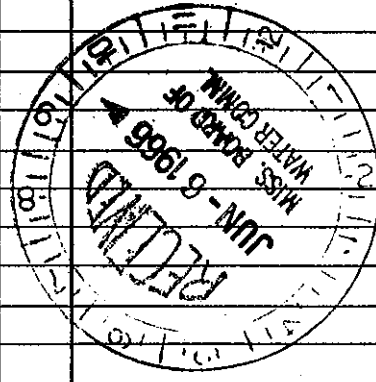

(Use Back Side)

Well No.

Mail this copy to Board of Water Commissioners 429 Miss. St. Jackson, Miss