


Mississippi Board of Water Commissioners 429 Miss. St. Jackson, Miss. Mail this copy to Board of Water Commissioners 429 Miss. St. Jackson, Miss.

Well No.

(Use Back Side)

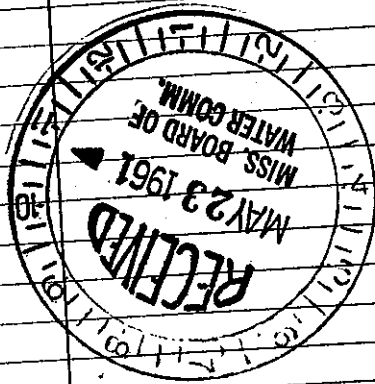

Information upon completion of well:

- (1) Diameter — 2 1/2 inches
- (2) Total Depth — 27 feet.
- (3) Water Level — 105 feet below top of ground.
- (4) Cased to — Size
- (5) Screen: Size — Length
- (6) Were any formations sealed against pollution? — yes, — no.

(4) Purpose of Well: Domestic Irrigation, Municipal, Industrial, Other

(3) Topography: Hills (Name) (Town)

miles of (distance) (direction) of (Nearest Town)

(2) Location: (Address) 87N162

(1) Kind of Land: (Name)

Driller: Name

Date: 19 1961  
 County: Lauderdale  
**MISSISSIPPI BOARD OF WATER COMMISSIONERS**  
**WATER WELL DRILLERS LOG**  
 67N162  
 1-25-61/25

200 ft. Blue clay  
 33 ft. Water down  
 Thick - Depth  
 Description & Color of Materials  
 25 ft. Water down  
 33 ft. Water down  
 200 ft. Blue clay  
 33 ft. Water down

Here on E side of  
 on this corner  
 plot are the  
 same in every  
 way.