

MISSISSIPPI BOARD OF WATER COMMISSIONERS

WATER WELL DRILLERS LOG


LADD
H 17
10-14-61

Date: 10.14, 1961, Driller: McDonald Hill County, Lauderdale

Depth Feet	Thick- ness Feet	Description & Color of Materials Sand, Clay, Red Clay, Shell, etc.	(1) Owner of Land: G H BONIE (Name)	(2) Location: MARION MISS 7N 10E % Sec. 13 T. R. 6 miles NORTH of Meridian (distance) (direction) (Nearest Town)	(3) Topography: X (Hilly) (Flat) (Level)	(4) Purpose of Well: DOMESTIC (Domestic Irrigation, Industrial, Other)
0	8	YELLOW CLAY				
8	16	SAND				
16	18	LIGHITE				
18	24	SABLE				
24	28	ROCK				
28	80	SABLE				
80	120	SANDY SHALE				
120	160	SHALE				
160	190	SOFT SHALE ST SAND				
190	225	SHALE				
225	245	SAND				

Information upon completion of well:
 (1) Diameter 6" inches.
 (2) Total Depth 240' feet.
 (3) Water Level 58' feet below top of ground.
 (4) Cased to 230' size 4" X 2"
 (5) Screen: Size 2" length 6'
 (6) Were any formations sealed against pollution? yes, no.

If YES depth of formation _____
 Why _____
 Drillers Remarks: _____

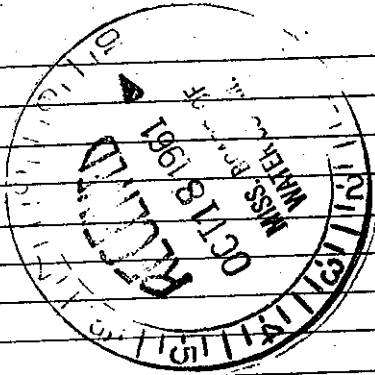

Well No.

(Use Back Side)

Mail this copy to Board of Water Commissioners 429 Miss. St. Jackson, Miss.