

MISSISSIPPI BOARD OF WATER COMMISSIONERS

WATER WELL DRILLERS LOG

Date: 11-19-63, Driller: M^r Donald Hill County Landmarks

(1) Owner of Land: J. H. Cook

(2) Location: Rt #1, Min. N. 1/2, Sec. 11, T. 17 N., R. 10 E.

(3) Topography: (Hilly) (Flat) (Level)

(4) Purpose of Well: DOMESTIC

(5) Information upon completion of well:

(6) Diameter: 4" inches.

(7) Total Depth: 225' feet.

(8) Water Level: 85' feet below top of ground.

(9) Cased to 154' Size 4"

(10) Screen: Size _____ Length _____

(11) Were any formations sealed against pollution? _____

(12) Why _____

(13) Drillers Remarks: _____

Description & Color of Materials
Sand, Clay, Red Clay, Shell, etc.

Thick-ness Feet

Depth Feet

CLAY

20 100

100 107

107 108

108 109

109 168


168 225

SANDY SHALE

ST SAND 168 225

Well No.

(Use Back Side)

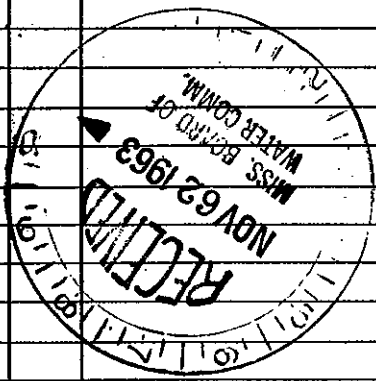

Mail this copy to Board of Water Commissioners 429 Miss. St. Jackson, Miss.