

MISSISSIPPI BOARD OF WATER COMMISSIONERS

L.A.O. H 24

WATER WELL DRILLERS LOG

Date: 6-14-65, 19 5, Driller: McDaniel & Hill, County: Lauderdale

(1) Owner of Land: H.E. Sanders

(2) Location: Pt 4 McDaniel, Miss. (Address) 57116


(3) Topography: 4 miles north of Meridian, Miss. (Nearest Town)

(4) Purpose of Well: Domestic (Level) (Flat) (Hilly) (Domestic Irrigation, Municipal, Industrial, Other)

(1) Diameter: 4 inches
 (2) Total Depth: 280 feet
 (3) Water Level: 69 feet below top of ground
 (4) Cased to: 227 feet
 (5) Screen: Size 8" Length 8"

(6) Were any formations sealed against pollution? yes, no
 If YES depth of formation
 Why
 Drillers Remarks:

Depth	Description & Color of Materials	Well No.
0-10	Clay	
10-40	Clay	
40-50	Shale, lg. st.	
50-60	Soft to sh. ch. l.	
60-100	Sh. in shale	
100-120	H brown shale	
120-130	Yellow shale	
130-146	Soft sandy shale	
146-147 1/2	Rock	
147 1/2-172	Sandy shale	
172-180	M shale	
180-225	fine sand	
225-231	fine sand	
231-280	Soft shale w/ sand	

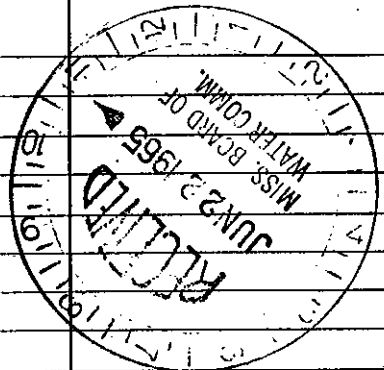

Mail this copy to Board of Water Commissioners 429 Miss. St. Jackson, Miss.