

MISSISSIPPI BOARD OF WATER COMMISSIONERS

LAND.

H 26

8-16-66

WATER WELL DRILLERS LOG

Date: 8/16/66, Driller: Jerry Dunning, 1966, County: Lard.

(1) Owner of Land: FRANK RALEY

(Name) RT 4 MERIDIAN

(Address) 7N 16E

(2) Location: 1/4, Sec 3 T 1 R

5 miles N of M.D.S.

(3) Topography: (Hilly) (Flat) (Level)

(4) Purpose of Well: DOMESTIC (Domestic Irrigation, Industrial, Other)

Information upon completion of well:

(1) Diameter: 7 inches.

(2) Total Depth: 368 feet.

(3) Water Level: 120 feet below top of ground.

(4) Cased to: 212, Size: 4

(5) Screen: Size: No. Length:

(6) Were any formations sealed against pollution? no.

YES depth of formation

Drillers Remarks:

Description & Color of Materials

Yellow clay

SAND - GRAY

HARD SHALE

SAND

0 65-

65 190

190 300


300 368

Depth

Thick-

ness

Feet

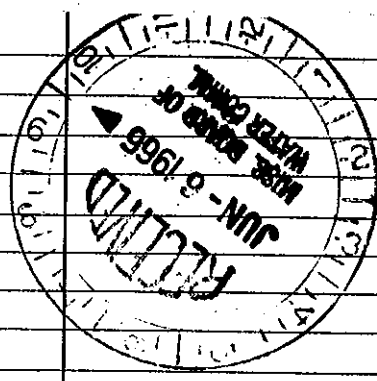

We