


Mail this copy to Board of Water Commissioners 429 Miss. St. Jackson, Miss.

Well No.	Thick-ness Feet	Depth	Description & Color of Materials Sand, Clay, Red Clay, Shell, etc.
	0	20	Clay
	20	35	Clay
	35	58	Heavy clay
	58	105	Heavy clay
	105	145	Soft mud
	145	205	Soft mud
	205	260	Mud & heavy mud
	260	310	Heavy mud & heavy mud

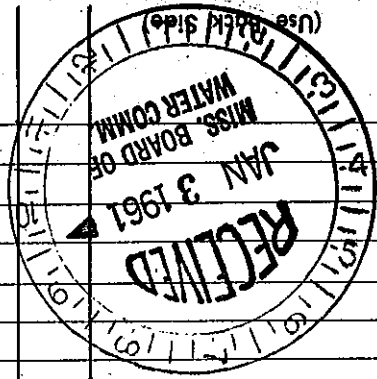

CODED

Information upon completion of well:

(1) Diameter 4" inches.

(2) Total Depth 310' feet.

(3) Water Level 127' feet below top of ground.

(4) Cased to 190' Size 4"

(5) Screen: Size _____, Length _____

(6) Were any formations sealed against pollution? _____ yes, _____ no.

If YES depth of formation _____

Why _____

Drillers Remarks: _____

(1) Owner of land: Bill Shultz (Name)

#4 Meridian (Address)

PA 716 (Address)

(2) Location: _____ 1/4, Sec. _____, T. _____, R. _____

3 miles North of Meridian (direction) (Nearest Town)

(3) Topography: X (Hilly) (Flat) (Lays)

(4) Purpose of Well: Domestic (Domestic Irrigation, Municipal, Industrial, Other)

Date: 12-3-60 Driller: McJannet County: Lauderdale

WATER WELL DRILLERS LOG

CODED