

MISSISSIPPI BOARD OF WATER COMMISSIONERS

WATER WELL DRILLERS LOG

CODED

Date: 9-21, 1961, Driller: McDonald Hill County, Louisiana

(1) Owner of Land: **MRS CLARA MILLER**

(Name) **BAILEY STAR ROUTE**
(Address) **30 7 16**

(2) Location: $\frac{1}{4}$ Sec. $\frac{1}{4}$ T. R. **2** miles **N WEST of MERIDIAN**
(distance) (direction) (Nearest Town)

(3) Topography: **X** (Hilly) (Flat) (Level)
(4) Purpose of Well: **DOMESTIC**
(Domestic Irrigation, Municipal, Industrial, Other)

Information upon completion of well:

- (1) Diameter: **4 3/4** inches.
- (2) Total Depth: **200** feet.
- (3) Water Level: **124** feet below top of ground.
- (4) Cased to: **148** feet, Size: **3**"
- (5) Screen: Size _____, Length _____
- (6) Were any formations sealed against pollution? _____
Yes, _____ no.

If YES depth of formation _____


Why _____

Drillers Remarks:

Description & Color of Materials
Sand, Clay, Red Clay, Shell, etc.

Thick-ness Feet	Depth Feet	CLAY
0 15		
	15 28	YELLOW SAND
	28 54	BLUE SHALE
	54 80	SANDY CLAY
	80 90	YELLOW SAND
	90 152	SHALE
	152 200	SANDY SHALE
		ST FINE

CODED

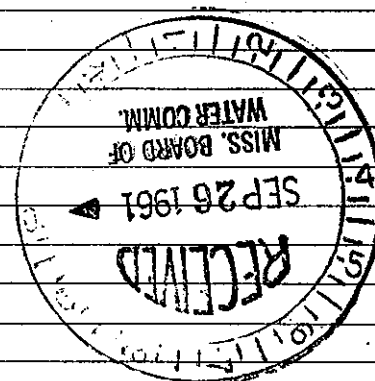

(Use Back Side)
Well No.

L.A.O.
H 54
9-21-61