


Mississippi Board of Water Commissioners 429 Miss. St. Jackson, Miss.

Well No.	(Use Back Side)
013	Clay
1370	H shale
7080	S shale
8888	Sandy shale
8889	Rock
8999	Soft shale
99148	Sandy shale
148150	Shale

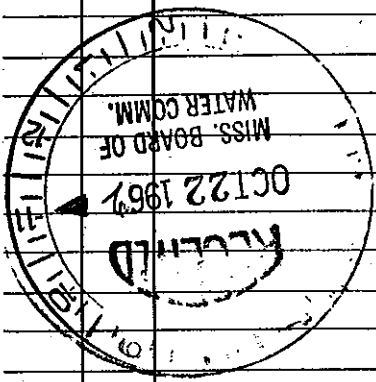

CODED

(1) Owner of Land: B.H. Barnes (Name)

(2) Location: 27 7/8 ^{1/4}, N of Meridian (Address) (direction) (Nearest Town)

(3) Topography: 8 miles (distance) (Hilly) (Flat) (Level)

(4) Purpose of Well: Domestic (Domestic Irrigation, Industrial, Other)

Information upon completion of well:

(1) Diameter: 4 inches.

(2) Total Depth: 150 feet.

(3) Water Level: 12 feet below top of ground.

(4) Cased to: 63 Size 4 Length

(5) Screen: Size _____ Length _____

(6) Were any formations sealed against pollution? yes no.

If YES depth of formation _____

Why _____

Drillers Remarks: _____

Mississippi Board of Water Commissioners

WATER WELL DRILLERS LOG

CODED

Date: 8-2-62, 1962, Driller: McDonald

H 55

8-2-62

L 900