

MISSISSIPPI BOARD OF WATER COMMISSIONERS

LH40

H 59

11-11-63

WATER WELL DRILLERS LOG

CODED


Date: 11-11, 1963, Driller: m. E. Donald Hill, Jr. County: Lauderdale

(1) Owner of Land: *Core Bailer* (Name)
Bailing Core Bailer (Address)
 Location: $\frac{1}{4}$, $\frac{1}{4}$, Sec. 19, T. 714 R. 19
 2 miles *N EAST* of *MERIDIAN* (direction) (Nearest Town)
 (3) Topography: *X* (Hilly) (Flat) (Level)
 (4) Purpose of Well: (Domestic Irrigation, Industrial, Other)

Information upon completion of well:
 (1) Diameter: $3\frac{1}{2}$ inches, TEST HOLE
 (2) Total Depth: 284 feet.
 (3) Water Level: 121 feet below top of ground.
 (4) Cased to 84' Size 3"
 (5) Screen: Size 147' Length 2'
 (6) Were any formations sealed against pollution? _____ yes, _____ no.
 IF YES depth of formation _____
 Why _____
 Drillers Remarks: _____

Thick-ness Feet	Depth	Description & Color of Materials Sand, Clay, Red Clay, Shell, etc.
0 10	0 10	CLAY
10 30	10 30	SAND ST CLAY
20 44	20 44	SHALE
44 74	44 74	SAND ST CLAY
74 140	74 140	SHALE
140 168	140 168	SANDY SHALE
168 201	168 201	SHALE
201 204	201 204	LIME ROCK
204 220	204 220	SHALE
220 223	220 223	LIME ROCK
223 292	223 292	SHALE
292 293	292 293	ROCK
293 294	293 294	SANDY SHALE ST
294 284	294 284	SAND

CODED

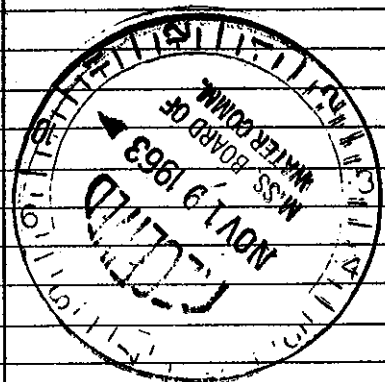

at this copy to Board of Water Commissioners 429 Miss. St. Jackson, Miss