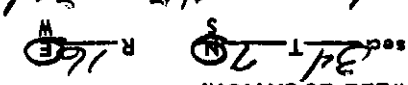


MISSISSIPPI  
 BOARD OF WATER COMMISSIONERS  
 416 North State Street  
 Jackson, Mississippi 39201  
**CODED**

WATER WELL DRILLERS LOG

date well completed Nov 7 1972  
 well name 72 George W. King & Sons  
 county well located

**L ANDERDALE**  
 H 71  
 11-4-72

LANDOWNER: <u>Geo. Johnson</u>	
WELL LOCATION: <u>PT 8, Miller Tract</u> (mailing address)	
	
miles <u>1</u> of <u>NE</u> (direction) (nearest town)	
WELL PURPOSE: <u>Farm</u> (home, irrigation, municipal, industrial)	
WELL COMPLETION DATA:	
(1) diameter (inches) <u>4"</u>	(2) total depth (feet) <u>320</u>
(3) static water level (feet) <u>35</u> below top of ground	(4) casing (material) (depth) <u>Steel 168</u>
(5) screen (size) (length) (depth to top) <u>No</u>	(6) pump (size) (material) (HP) (yield gpm) <u>1 1/2 8</u>
(7) electric log (yes or no) <u>No</u>	(8) how well bottom plugged <u>Good</u>
DRILLERS REMARKS:	

**CODED**

**NOV 18 1972**

description of formations encountered	from	to
<u>yellow</u>	<u>0</u>	<u>15</u>
<u>blue clay</u>	<u>15</u>	<u>40</u>
<u>clay &amp; sand</u>	<u>40</u>	<u>180</u>
<u>clay</u>	<u>180</u>	<u>220</u>
<u>clay</u>	<u>220</u>	<u>260</u>
<u>clay</u>	<u>260</u>	<u>320</u>