

MISSISSIPPI DEPARTMENT OF NATURAL RESOURCES

Bureau of Land and Water Resources

Southport Mall

P.O. Box 10631


Jackson, Mississippi 39209

WATER WELL DRILLERS LOG

firm name  
19 *Bo Young Drilling Co. Inc.*  
county well located

LANDMAN
H
2054
6/25

description of formations encountered	from	to	depth (feet)	total depth (feet)	static water level (feet)	top of ground	casing (material)	screen (length)	screen (depth to top)	size	if telescope see back	(1) diameter (inches)	(2) total depth (feet)	(3) static water level (feet)	(4) casing (material)	(5) screen (length)	(6) pump (size)	(7) electric log (yes or no)	(8) how well bottom plugged	DRILLERS REMARKS:
			0	18	18	45						4"	420	45 below	PC 220		3/4"	5HP	good	
			18	45	45	157														
			45	157	157	200														
			157	200	200	320														
			200	320	320	420														
			320	420	420															

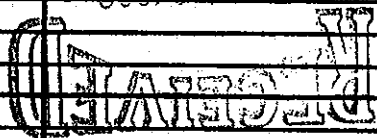

SEP 19 1980

Department of Natural Resources  
Bureau of Land & Water Resources