

LAUD. MISSISSIPPI BOARD OF WATER COMMISSIONERS

J2
7-6-60

WATER WELL DRILLERS LOG

Date: 7-6, 1960, Driller: Peoples of Rutledge County, Woodward
(Name)

		Description & Color of Materials Sand, Clay, Red Clay, Shell, etc.	Thick- ness Feet	Depth Feet
(1) Owner of Land: <u>Lamar Smith</u> (Name)		Top Soil to Clay	12	12
<u>Toomsuka Miss.</u> (Address)		Red Clay	8	20
(2) Location: <u>34 7N 17E</u>		Grey Shale & lignite	11	31
<u>3</u> miles <u>West</u> of <u>Toomsuka</u> (distance) (direction) (Nearest Town)		Sandy Shale	32	63
(3) Topography: <u>Hilly</u> (Hilly) (Flat) (Level)		Shale & lignite	20	83
(4) Purpose of Well: <u>Domestic</u> (Domestic Irrigation Municipal, Industrial, Other)		Sandy Shale	22	105
		Fine Sand. Shale Bks.	11	115
		Shale & Sand.	11	126
		Shale	21	147
		Sand White	21	168

Information upon completion of well:


- (1) Diameter 2 inches.
- (2) Total Depth 168 feet.
- (3) Water Level 480 feet below top of ground.
- (4) Cased to 160, Size 2"
- (5) Screen: Size 2", Length 6
- (6) Were any formations sealed against pollution?
_____ yes, _____ no.

If YES depth of formation _____

Why _____

Drillers Remarks: Water Has

High Iron Content -

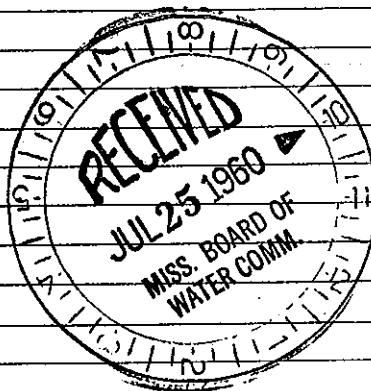

(Use Back Side)

Well No.

Mail this copy to Board of Water Commissioners 429 Miss. St. Jackson, Miss