

LAUD. MISSISSIPPI BOARD OF WATER COMMISSIONERS

J3

10-14-63

WATER WELL DRILLERS LOG

Date: 10-14, 1963, Driller: Mr. Donald Hill County Lauderdale
(Name)

| (1) Owner of Land | Description & Color of Materials Sand, Clay, Red Clay, Shell, etc. | Thick- ness Feet | Depth Feet |
|---|---|------------------------|---------------|
| R. E. Brannon (Name) | Clay | 0 | 0 |
| Rt. #1, town sub (Address) | Sand | 5 | 28 |
| (2) Location: 1/4, 1/4, Sec. 24 T. R. | Shale | 28 | 78 |
| 1 miles NW of <u>Thomson</u> (distance) (direction) (Nearest Town) | Sand | 78 | 83 |
| 7N17E | Shale | 83 | 86 |
| (3) Topography: <u>Hilly</u> (Hilly) (Flat) (Level) | Sand & sandy shale | 86 | 106 |
| (4) Purpose of Well: <u>Domestic</u> (Domestic Irrigation Municipal, Industrial, Other) | Shale | 106 | 120 |
| | Sand & sandy shale | 120 | 120 |
| | Shale | 120 | 164 |
| | Hard lime rock | 164 | 160 |
| | Sandy shale | 165 | 170 |
| | Coarse sand | 170 | 185 |


Information upon completion of well:

- (1) Diameter 3 1/8 inches.
- (2) Total Depth 195 feet.
- (3) Water Level 65 feet below top of ground.
- (4) Cased to 140, Size 4x2.
- (5) Screen: Size 2", Length 5'.
- (6) Were any formations sealed against pollution?
_____ yes, _____ no.

If YES depth of formation _____

Why _____

Drillers Remarks: _____

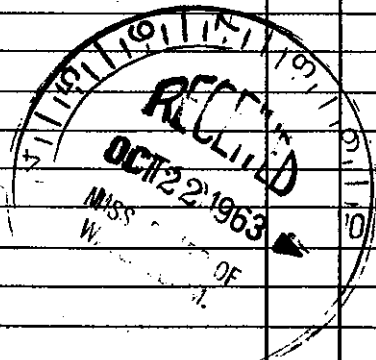

Well No. 114

(Use Back Side)

Mail this copy to Board of Water Commissioners 429 Miss. St. Jackson, Miss.