

LAUD. MISSISSIPPI BOARD

J4

2-17-64

WATER WELL DRILLERS LOG

Date: 2-17, 1964, Driller: Jerry County: Laud

(1) Owner of Land: *The Fruit near Home*
(Name) *association*
Russell, Miss.
(Address)
(2) Location: $\frac{1}{4}$, $\frac{1}{4}$, Sec. *31* T *17N* R
11 miles *NE*, of *McN*
(distance) (direction) (Nearest Town)
(3) Topography: (Hilly) (Flat) (Level)
(4) Purpose of Well: *Church*
(Domestic Irrigation
Municipal, Industrial, Other)


Description & Color of Materials Sand, Clay, Red Clay, Shell, etc.	Thick- ness Feet	Depth Feet
<i>yellow sand</i>	<i>0</i>	<i>95</i>
<i>sand + clay mix</i>	<i>95</i>	<i>250</i>
<i>blue dirt</i>	<i>250</i>	<i>375</i>
<i>sandy</i>	<i>375</i>	<i>427</i>

Information upon completion of well:

(1) Diameter: *4* inches.
(2) Total Depth: *427* feet.
(3) Water Level: *315'* feet below top of ground.
(4) Cased to: *367* Size: *4"*
(5) Screens: Size: *No*, Length: _____
(6) Were any formations sealed against pollution?
_____ yes, no.

if YES depth of formation _____
Why _____

Drillers Remarks: *water stands very low in well but pumps 15 gpm*

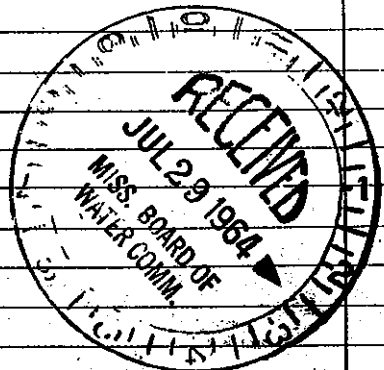

W