

LAUD.
J⁹
7-6-60

MISSISSIPPI BOARD OF WATER COMMISSIONERS

WATER WELL DRILLERS LOG

Date: 7-6, 1960, Driller: Peoples & Rutledge County Lauderdale.
(Name)


(1) Owner of Land: <u>James Prindle</u> (Name)	Description & Color of Materials Sand, Clay, Red Clay, Shell, etc.	Thick- ness Feet	Depth Feet
<u>Coombsville Miss</u> (Address)	Red Sandy Clay	12	12
(2) Location: <u>1/4</u> , <u>1/4</u> , Sec. <u>24 7N17E</u> T R	yellow clay	13	25
_____ miles _____ of _____ (distance) (direction) (Nearest Town)	lignite	6	31
(3) Topography: <u>Hilly</u> (Hilly) (Flat) (Level)	Hard Shale.	74	105
(4) Purpose of Well: <u>Domestic</u> (Domestic Irrigation Municipal, Industrial, Other)	lignite	3	108
	Sandy Shale	35	147
	Sandy Shale & Hard Sand	52	199
	Sandy Shale.	20	219
	[Fine Hard Packed. Sand & Shale	50	270

Information upon completion of well:

- (1) Diameter 4" inches.
- (2) Total Depth 270 feet.
- (3) Water Level 90 feet below top of ground.
- (4) Cased to 60, Size 4"
- (5) Screen: Size open, Length _____
- (6) Were any formations sealed against pollution?
_____ yes, _____ no.

If YES depth of formation _____
Why _____

Drillers Remarks: Limited Yield.
Good Water.

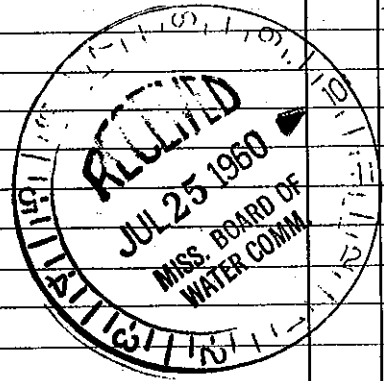

Well No. _____

(Use Back Side)

Mail this copy to Board of Water Commissioners 429 Miss. St. Jackson, Miss