

LAUD. MISSISSIPPI BOARD OF WATER COMMISSIONERS


J 11

10-31-63

WATER WELL DRILLERS LOG

Date: 10-31, 1963, Driller: McDonald & Hill County Anderson
 (Name)

| (1) Owner of Land: <u>W.T. Peterson</u> (Name) | Description & Color of Materials Sand, Clay, Red Clay, Shell, etc. | Thick- ness Feet | Depth Feet |
|---|---|------------------------|---------------|
| <u>Rt #6, Meridian</u> (Address) | <u>Clay</u> | <u>0</u> | <u>17</u> |
| (2) Location: <u>1/4, 1/4, Sec. 7 N 17 E</u> (distance) (direction) (Nearest Town) | <u>Sdy. Clay & sd</u> | <u>17</u> | <u>22</u> |
| (3) Topography: <u>Hilly</u> (Hilly) (Flat) (Level) | <u>Shale</u> | <u>22</u> | <u>110</u> |
| (4) Purpose of Well: <u>Domestic</u> (Domestic Irrigation Municipal, Industrial, Other) | <u>Shale w/ lig. streaks</u> | <u>110</u> | <u>130</u> |
| Information upon completion of well: | <u>Sdy. shale w/ some sd</u> | <u>130</u> | <u>135</u> |
| (1) Diameter: <u>3 7/8</u> inches. | <u>Shale w/ lig. streaks</u> | <u>135</u> | <u>270</u> |
| (2) Total Depth: <u>350</u> feet. | <u>Hard & sdy. shale</u> | <u>270</u> | <u>280</u> |
| (3) Water Level: <u>200</u> feet below top of ground. | <u>Sand</u> | <u>280</u> | <u>287</u> |
| (4) Cased to: <u>251</u> , Size <u>4"</u> | <u>Sandy shale</u> | <u>287</u> | <u>290</u> |
| (5) Screen: Size _____, Length _____ | <u>Shale</u> | <u>290</u> | <u>300</u> |
| (6) Were any formations sealed against pollution? _____ yes, _____ no. | <u>Sdy. shale w/ some sd</u> | <u>300</u> | <u>310</u> |
| If YES depth of formation _____ | <u>Sand (fine)</u> | <u>315</u> | <u>345</u> |
| Why _____ | <u>Sdy. shale</u> | <u>345</u> | <u>350</u> |
| Drillers Remarks: _____ | | | |

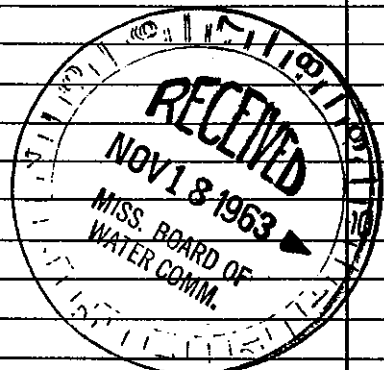

Well
12