

LAUD. MISSISSIPPI BOARD OF WATER COMMISSIONERS

J13

12-14-65

WATER WELL DRILLERS LOG

Date: 12/14, 1965, Driller: Seay Drilling County LAUD.
(Name)

(1) Owner of Land: Curtis Hill
(Name)

TOOMSUBA, Miss
(Address)

(2) Location: 1/4, 1/4, Sec. 17 N 17 E
T R

15 miles NE, of MDN.
(distance) (direction) (Nearest Town)

(3) Topography: Flat
(Hilly) (Flat) (Level)

(4) Purpose of Well: DOMESTIC
(Domestic Irrigation, Municipal, Industrial, Other)

Description & Color of Materials Sand, Clay, Red Clay, Shell, etc.	Thick- ness Feet	Depth Feet
<u>YELLOW SAND + CLAY</u>	<u>0</u>	<u>55</u>
<u>BLUE dirt</u>	<u>55</u>	<u>220</u>
<u>Good SAND</u>	<u>220</u>	<u>280</u>

Information upon completion of well:

(1) Diameter 4 inches.

(2) Total Depth 280 feet.

(3) Water Level 31' feet below top of ground.

(4) Cased to 174, Size 4"


(5) Screen: Size no, Length _____

(6) Were any formations sealed against pollution?
 _____ yes, _____ no.

If YES depth of formation _____

Why _____

Drillers Remarks: Good WATER

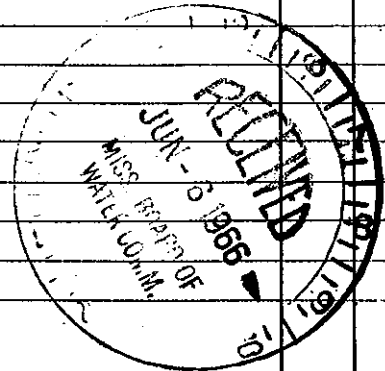

(Use Back Side)

Well No.

Retain this copy for your office files.