

LAUDERDALE

J 15

12-67

MISSISSIPPI BOARD OF WATER COMMISSIONERS
416 North State Street
Jackson, Mississippi 39201

WATER WELL DRILLERS LOG

12-27

date well completed

1967 Jerry Drilling

firm name

Laud

county well located

LANDOWNER:

Jim Cardwell
Lauderdale Miss.
(mailing address)

description of formations encountered

from to

yellow sand & clay	0	45
blue clay	45	115
fine sand	115	130
blue clay	130	180
sandy	180	212


WELL LOCATION:

sec. 2 T 7 N R 17 E
S W
2 miles south of Lauderdale
(distance) (direction) (nearest town)

WELL PURPOSE: HOME
(home, irrigation, municipal, industrial)

WELL COMPLETION DATA:

- (1) diameter (inches) 2"
- (2) total depth (feet) 212'
- (3) static water level (feet) 65' below top of ground.
- (4) casing 2" galv. 206' (material) (depth)
No (size) if telescope see back.
- (5) screen 2" 6' 206' (length) (depth to top)
2" Stainless (size) (material)
- (6) pump Jet 6 gpm 3/4 H.P. (HP) (yield gpm) (type power)
- (7) electric log No (yes or no)
(organization running log)
- (8) how well bottom plugged Wash Valve

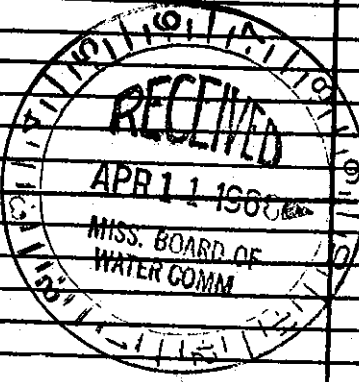

DRILLERS REMARKS:

20' good sand in bottom