

3 13 K

322425N0883125

TE TU

Lauderdale
Q 18
10-8-68

MISSISSIPPI
 BOARD OF WATER COMMISSIONERS
 416 North State Street
 Jackson, Mississippi 39201

WATER WELL DRILLERS LOG


10-8-68 McDONALD + HILL LAUDERDALE
 date well completed firm name county well located

LANDOWNER: <u>RL POWELL</u> <u>TOOMSUBA MISS</u> (mailing address)	description of formations encountered	CODE	
		from	to
	CLAY	0	18
	SHALE	18	45
	SAND ST SHALE	45	110
	SHALE	110	140
	SOFT SHALE	140	190
	SHALE	190	230
	SOFT SHALE	230	250
	SAND	250	280

WELL LOCATION:
 sec. 23 T 7 N R 17 E
 S W
2 miles NORTH of TOOMSUBA
 (distance) (direction) (nearest town)

WELL PURPOSE:
 (home, irrigation, municipal, industrial)

- WELL COMPLETION DATA:
- (1) diameter (inches) 4"
 - (2) total depth (feet) 280'
 - (3) static water level (feet) 115 below top of ground.
 - (4) casing PVC, 200'
 (material) (depth)
4"
 (size) if telescope see back.
 - (5) screen 6', 274'
 (length) (depth to top)
2", PVC
 (size) (material)
 - (6) pump 1, 10
 (HP) (yield gpm)
220
 (type power)
 - (7) electric log NO
 (yes or no)
NO
 (organization running log)
 - (8) how well bottom plugged VALVE

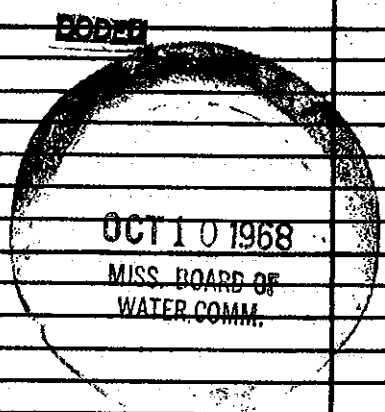

DRILLERS REMARKS: