

MISSISSIPPI BOARD OF WATER COMMISSIONERS

WATER WELL DRILLERS LOG

CODED J 301

LAUD.
J 50
8-9-60

Date: 8/9, 1960, Driller: M. E. Donald & H. W. [unclear] County: Lauderdale

(Name)

(1) Owner of Land:	Description & Color of Materials Sand, Clay, Red Clay, Shell, etc.	Thick- ness Feet	Depth Feet
(Name) <u>Security Building</u> (Address) <u>Meridian, Miss</u> <u>24 417</u>	<u>Clay</u> <u>marsh</u> <u>medium sand</u>	<u>0</u> <u>28</u> <u>118</u>	<u>28</u> <u>118</u> <u>155</u>
(2) Location: <u>1/4</u> , <u>1/4</u> , Sec. <u>T</u> <u>R</u>			
<u>1</u> miles <u>N.W.</u> , of <u>Transub</u> (distance) (direction) (Nearest Town)			
(3) Topography: <u>Hilly</u>			
(4) Purpose of Well: <u>Domestic</u>			

CODED


Information upon completion of well:

- (1) Diameter 2 inches.
- (2) Total Depth 155 feet.
- (3) Water Level 54 feet below top of ground.
- (4) Cased to 155, Size 2 inch
- (5) Screen: Size 2, Length 5 ft
- (6) Were any formations sealed against pollution?
 yes, no.

If YES depth of formation _____

Why _____

Drillers Remarks: _____

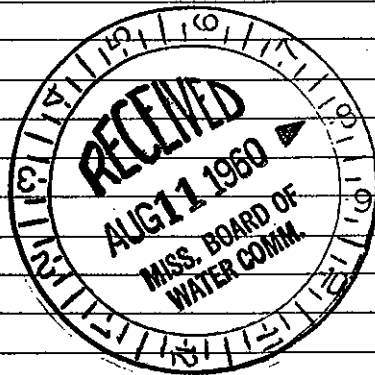

Well No.

(Use Back Side)

Mail this copy to Board of Water Commissioners 429 Miss. St. Jackson, Miss.