

LAUD.
J 51
1-12-61

MISSISSIPPI BOARD OF WATER COMMISSIONERS

WATER WELL DRILLERS LOG

CODED

Date: 1-12, 1961, Driller: M. Donald & Hill County
(Name)

(1) Owner of Land: R. L. Powell
(Name)
Transubia, Miss
(Address)

(2) Location: 1/4, 1/4 Sec. 7, 17
_____ miles _____ of _____
(distance) (direction) (Nearest Town)

(3) Topography: Hilly
(Hilly) (Flat) (Level)

(4) Purpose of Well: Domestic
(Domestic Irrigation
Municipal, Industrial, Other)

Description & Color of Materials Sand, Clay, Red Clay, Shell, etc.	Thick- ness Feet	Depth Feet
<u>old well</u>	<u>0</u>	<u>118</u>
<u>soft manl</u>	<u>118</u>	<u>145</u>
<u>SOFT sandy manl</u>	<u>145</u>	<u>255</u>
<u>Sand!</u>	<u>255</u>	<u>280</u>

Information upon completion of well:

(1) Diameter 2 inches.

(2) Total Depth 280 feet.

(3) Water Level 115' feet below top of ground.


(4) Cased to 272, Size 2"

(5) Screen: Size 2", Length 6'

(6) Were any formations sealed against pollution?
_____ yes, no.

CODED

If YES depth of formation _____
Why _____
Drillers Remarks: _____

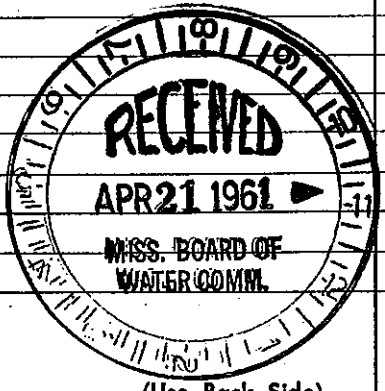

Well No. _____

Mail this copy to Board of Water Commissioners 429 Miss. St. Jackson, Miss.