

L.A.U.O.

MISSISSIPPI BOARD OF WATER COMMISSIONERS

WATER WELL DRILLERS LOG

**CODED**

J. 52  
2-14-61

Date: 2-14, 1961, Driller: McDonald & Hill County Lauderdale  
(Name)

(1) Owner of Land: Homer Byrum  
(Name)  
Coamsubers, Miss  
(Address)

(2) Location: 23.71 T. R. 1  
miles \_\_\_\_\_ of \_\_\_\_\_  
(distance) (direction) (Nearest Town)

(3) Topography:  (Hilly)  (Flat)  (Level)

(4) Purpose of Well: Domestic  
(Domestic Irrigation  
Municipal, Industrial, Other)

Description & Color of Materials Sand, Clay, Red Clay, Shell, etc.	Thick- ness Feet	Depth Feet
Clay	0	10
manl	10	22
Sand	22	24
Sandy Lime	24	60
Soft Lime	60	100
med. manl	100	150
Shale st. Fine Sand.	150	200

Information upon completion of well:

(1) Diameter 2" inches.

(2) Total Depth 200 feet.


(3) Water Level 70 feet below top of ground.

(4) Cased to 105, Size \_\_\_\_\_

(5) Screen: Size 1/4", Length \_\_\_\_\_

(6) Were any formations sealed against pollution?  
\_\_\_\_\_ yes,  no.

**CODED**

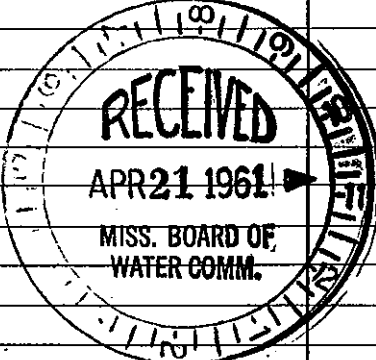

If YES depth of formation \_\_\_\_\_

Why \_\_\_\_\_

Drillers Remarks: \_\_\_\_\_

Well No.

(Use Back Side)

Mail this copy to Board of Water Commissioners 429 Miss. St. Jackson, Miss.