

MISSISSIPPI BOARD OF WATER COMMISSIONERS

LAUD.

J 53.

WATER WELL DRILLERS LOG

**CODED**

Date: 6-1, 1961, Driller: McDonald & Hill County Lauderdale

(Name)

(1) Owner of Land: Arthur Lee Wallace  
 (Name)  
Toomsboro, Miss.  
 (Address)

(2) Location: 2 1/4 Sec. 7 T. 17 R.  
1 miles North of Toomsboro  
 (distance) (direction) (Nearest Town)

(3) Topography:  (Hilly)  (Flat)  (Level)

(4) Purpose of Well: Domestic  
 (Domestic Irrigation, Municipal, Industrial, Other)

Description & Color of Materials Sand, Clay, Red Clay, Shell, etc.	Thick- ness Feet	Depth Feet
Clay	0	10
Sandy Clay	10	20
Shale	20	80
Sandy Shale & Sand	80	140
Shale	140	190
Fine Sand	190	200
Soft line	200	274
Med. Shale	274	289
Fine Sand	289	295
Sand	295	322

Information upon completion of well:

(1) Diameter 2" inches.

(2) Total Depth 320 feet.

(3) Water Level 145 feet below top of ground.

(4) Cased to 313, Size 2"

(5) Screen: Size 2", Length 6'


(6) Were any formations sealed against pollution?  
 yes,  no.

**CODED**

If YES depth of formation \_\_\_\_\_

Why \_\_\_\_\_

Drillers Remarks: \_\_\_\_\_

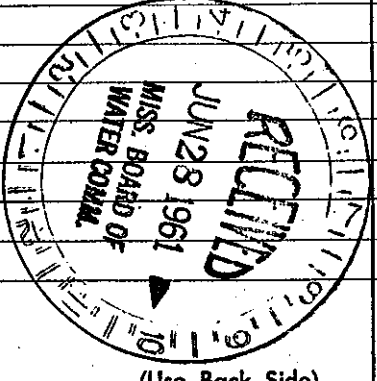

(Use Back Side)

Well No.