

LAUD.

MISSISSIPPI BOARD OF WATER COMMISSIONERS

J 55

WATER WELL DRILLERS LOG

**CODED**

7-10-62

Date: 7-10, 1962, Driller: M<sup>r</sup> Donald E. Hill County Lauderdale  
(Name)

		Description & Color of Materials Sand, Clay, Red Clay, Shell, etc.	Thick- ness Feet	Depth Feet
(1) Owner of Land:	<u>Vol Feltenstein</u> (Name) <u>Lauderdale, Miss.</u> (Address)	<u>Sand &amp; Clay</u>	<u>0</u>	<u>38</u>
(2) Location:	<u>1/4</u> , <u>1/4</u> , Sec. <u>7</u> <u>17</u> <u>1</u> miles <u>S.E.</u> , of <u>Lauderdale</u> (distance) (direction) (Nearest Town)	<u>Shale</u>	<u>38</u>	<u>63</u>
(3) Topography:	<input checked="" type="checkbox"/> (Hilly) <input type="checkbox"/> (Flat) <input type="checkbox"/> (Level)	<u>med. Sand</u>	<u>63</u>	<u>84</u>
(4) Purpose of Well:	<u>Domestic</u> (Domestic Irrigation Municipal, Industrial, Other)	<u>Coarse Sand</u>	<u>84</u>	<u>120</u>

**CODED**


Information upon completion of well:

- (1) Diameter 2 inches.
- (2) Total Depth 120 feet.
- (3) Water Level 14 feet below top of ground.
- (4) Cased to 105, Size 2"
- (5) Screen: Size 2, Length 5'
- (6) Were any formations sealed against pollution?  
yes,  no.

If YES depth of formation \_\_\_\_\_

Why \_\_\_\_\_

Drillers Remarks: \_\_\_\_\_

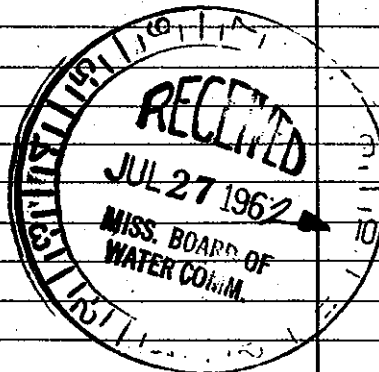

Well No. \_\_\_\_\_

(Use Back Side)

Mail this copy to Board of Water Commissioners 429 Miss. St. Jackson, Miss.