

LAUD.

MISSISSIPPI BOARD OF WATER COMMISSIONERS

J 56

7-10-62

WATER WELL DRILLERS LOG

CODED

Date: 7-10, 1962, Driller: McDonald Hill County: Independence
(Name)

(1) Owner of Land:	Description & Color of Materials Sand, Clay, Red Clay, Shell, etc.	Thick- ness Feet	Depth Feet
<u>Carlene Baswell Fulton</u> (Name)	<u>Clay</u>	<u>0</u>	<u>20</u>
<u>Rt #6 Meridian, Miss.</u> (Address)	<u>Sandy Clay</u>	<u>20</u>	<u>30</u>
(2) Location: <u>1/4, 33, Sec. 7, T. 14</u>	<u>Shale</u>	<u>30</u>	<u>50</u>
<u>5</u> miles <u>East</u> of <u>Meridian</u> (distance) (direction) (Nearest Town)	<u>Sand</u>	<u>50</u>	<u>80</u>
(3) Topography: <input checked="" type="checkbox"/> (Hilly) <input type="checkbox"/> (Flat) <input type="checkbox"/> (Level)	<u>Sandy Shale</u>	<u>80</u>	<u>95</u>
(4) Purpose of Well: <u>Domestic</u> (Domestic Irrigation, Municipal, Industrial, Other)	<u>Shale</u>	<u>95</u>	<u>160</u>
	<u>Fine Sand</u>	<u>160</u>	<u>170</u>
	<u>Shale soft</u>	<u>170</u>	<u>185</u>
	<u>Shale</u>	<u>185</u>	<u>262</u>
	<u>Sand</u>	<u>262</u>	<u>300</u>

Information upon completion of well:


- (1) Diameter 4 inches.
- (2) Total Depth 300 feet.
- (3) Water Level 100 feet below top of ground.
- (4) Cased to 190, Size 4
- (5) Screen: Size , Length _____
- (6) Were any formations sealed against pollution?
_____ yes, no.

If YES depth of formation _____

Why _____

Drillers Remarks: _____

CODED

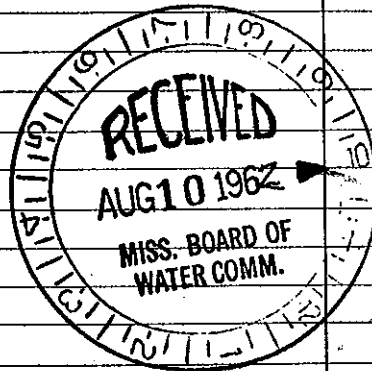

(Use Back Side)

Well No.

Mail this copy to Board of Water Commissioners 429 Miss. St. Jackson, Miss