

LAUD.
 J 58
 1-1-63
 Date: 1-1-1963

WATER WELL DRILLERS LOG **CODED**

Driller: Mc Donald - Hill County (Name)

(1) Owner of Land: Ed Ratcliff
 (Name)
Rt #1 Meridian
 (Address)

(2) Location: $\frac{1}{4}$, $\frac{1}{4}$, Sec. 7, 17
12 miles S of Meridian
 (distance) (direction) (Nearest Town)

(3) Topography: _____
 (Hilly) (Flat) (Level)

(4) Purpose of Well: Domestic
 (Domestic Irrigation
 Municipal, Industrial, Other)

| Description & Color of Materials Sand, Clay, Red Clay, Shell, etc. | Thick- ness Feet | Depth Feet |
|---|------------------------|---------------|
| Clay | 0 | 8 |
| Sand | 8 | 40 |
| Clay | 40 | 45 |
| Shale | 45 | 65 |
| Shale | 65 | 75 |
| Med Shale | 75 | 85 |
| Shale | 85 | 105 |
| Chalk | 105 | 190 |
| # 12 sand | 190 | 220 |

Information upon completion of well:

(1) Diameter 2 inches.

(2) Total Depth 200 feet.


(3) Water Level 150 feet below top of ground.

(4) Cased to 189, Size 2

(5) Screen: Size 12, Length 5

(6) Were any formations sealed against pollution?
 _____ yes, no.

CODED

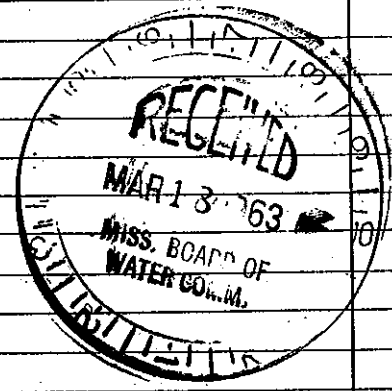

If YES depth of formation _____

Why _____

Drillers Remarks: _____

Well No.

(Use Back Side)

Retain this copy for your office files.