

LAUD.

MISSISSIPPI BOARD OF WATER COMMISSIONERS

J 59
1-4-64

WATER WELL DRILLERS LOG **CODED**

Date: 1-4, 1964, Driller: MCDONALD HILL County: Lauderdale

(Name)

(1) Owner of Land: Anderson ANDERSON
(Name)

RD 2 MERIDIAN
(Address)

(2) Location: 1/4, 1/4, 29 717 Sec. T R
(distance) (direction) (Nearest Town)

7 miles NORTH of MERIDIAN
(distance) (direction) (Nearest Town)

(3) Topography: X
(Hilly) (Flat) (Level)

(4) Purpose of Well: DOMESTIC
(Domestic Irrigation, Municipal, Industrial, Other)

Description & Color of Materials Sand, Clay, Red Clay, Shell, etc.	Thick- ness Feet	Depth Feet
<u>CLAY</u>	<u>0</u>	<u>22</u>
<u>SANDY CLAY</u>	<u>22</u>	<u>45</u>
<u>SHALE</u>	<u>45</u>	<u>80</u>
<u>SANDY</u>	<u>80</u>	<u>120</u>
<u>SHALE</u>	<u>120</u>	<u>370</u>
<u>SANDY SHALE</u>	<u>370</u>	<u>400</u>
<u>SHALE</u>	<u>400</u>	<u>495</u>
<u>SAND</u>	<u>495</u>	<u>512</u>

Information upon completion of well:

(1) Diameter 4" inches.

(2) Total Depth 512' feet.

(3) Water Level 68' feet below top of ground.

(4) Cased to 190', Size 4"

(5) Screen: Size _____, Length _____


(6) Were any formations sealed against pollution?
_____ yes, _____ no.

CODED

If YES depth of formation _____

Why _____

Drillers Remarks: _____

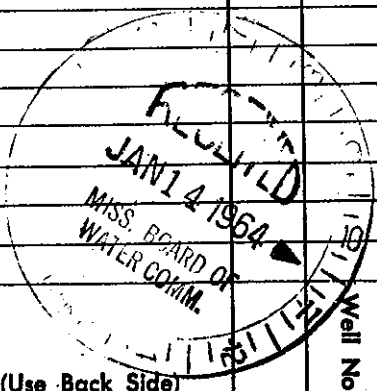

(Use Back Side)

Mail this copy to Board of Water Commissioners 429 Miss. St. Jackson, Miss.